





FOR LEASE  
COORDINATION  
11.04.2025  
REVISIONS ▾

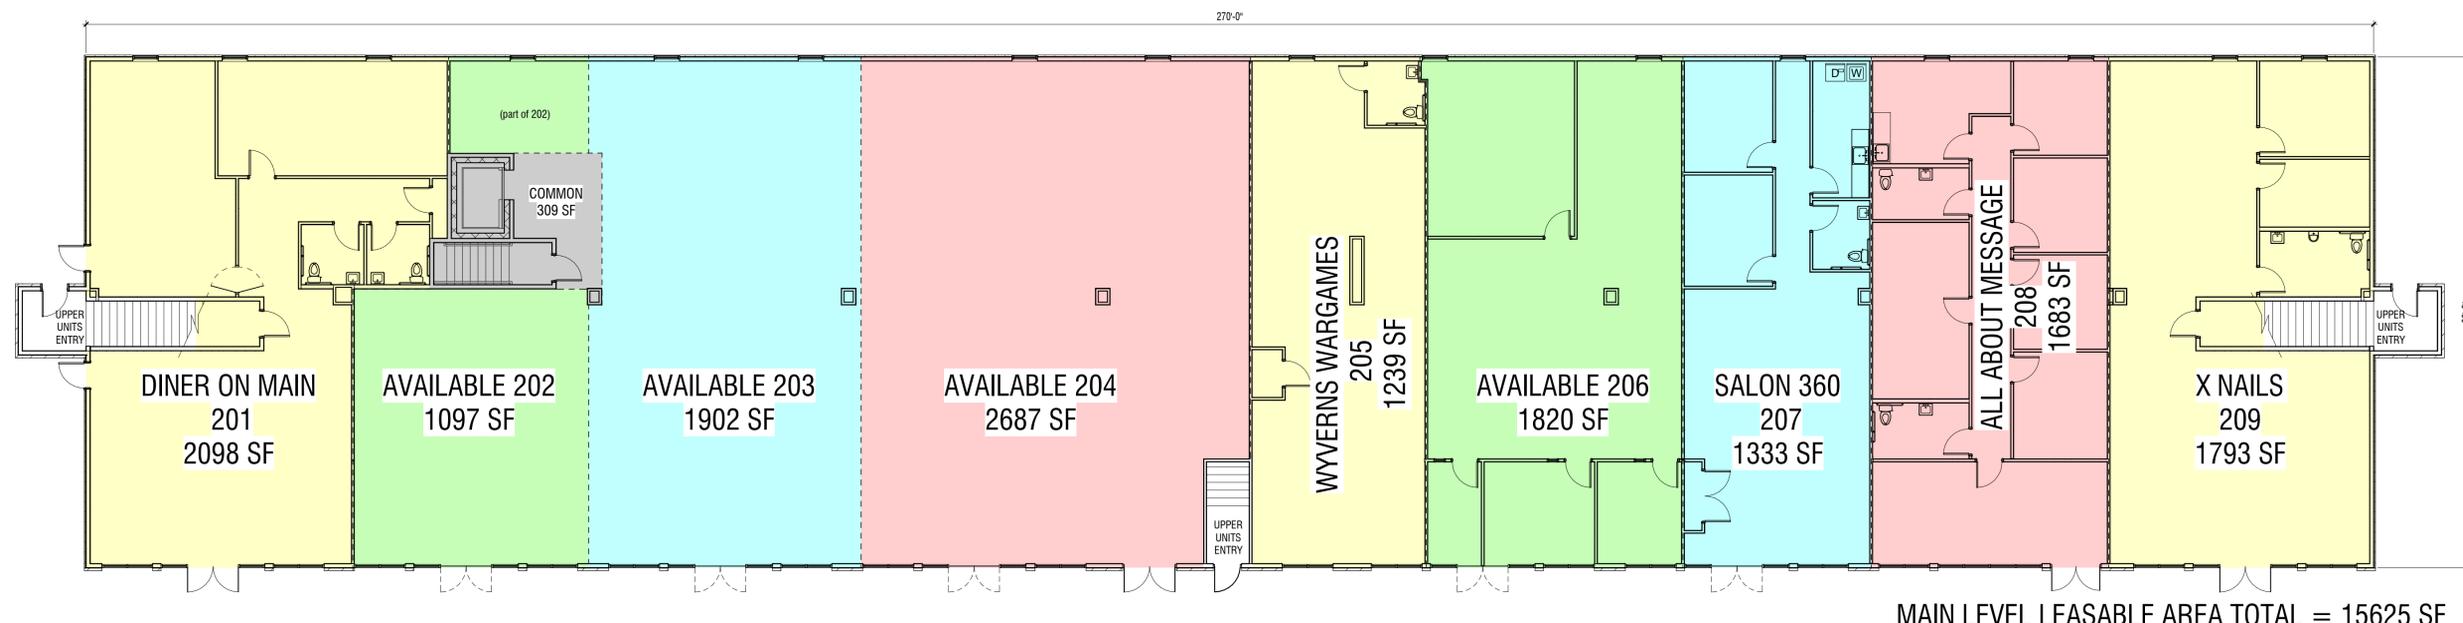

**1 FIRST FLOOR PLAN**  
SCALE: 1" = 10'-0" SHEET: A-1.1

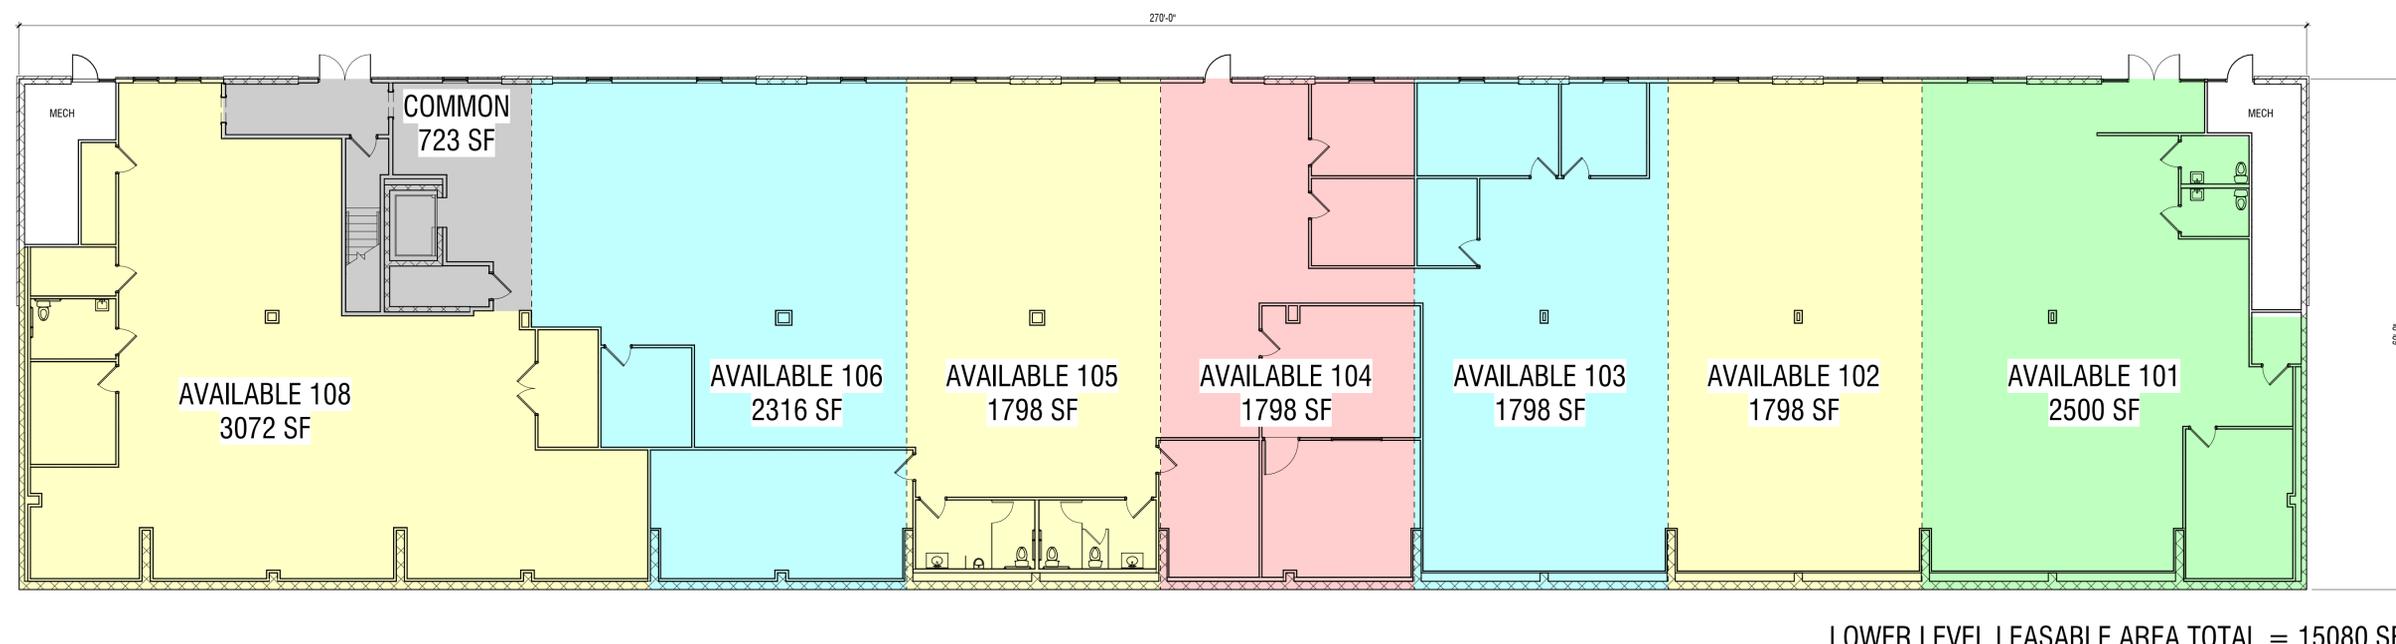

**0 LOWER LEVEL PLAN**  
SCALE: 1" = 10'-0" SHEET: A-1.1

Pinecrest Plaza  
Morgantown, WV

FLOOR PLANS



OMNI  
ARCHITECTS

A-1.1

Copyright © All rights reserved. Reproduction in whole or in part is prohibited. This drawing is an instrument of service, is the property of the Architect and may not be used in any way without written permission of this firm.  
Project No: 2023030 Drawn by: rlg

AS-BUILT FLOOR PLAN PROVIDED FOR LEASE ASSISTANCE ONLY